


Drainage Plan
1 : 50

****All dimensions taken from internal face of inner-leaf masonry****

Foul Chamber Schedule						
Chamber Ref.	Cover Level (m)	Invert Level (m)	Chamber Type	Chamber Size (mm)	Cover Type	Chamber Depth (m)
F1	41.680	41.230	Type 3	Ø 460mm	B125	0.450
F2	41.680	41.080	Type 3	Ø 460mm	B125	0.600
F3	41.680	40.980	Type 3	Ø 460mm	B125	0.700
F4	41.680	40.845	Type 3	Ø 460mm	B125	0.835
F5	41.680	40.650	Type 3	Ø 460mm	B125	1.030
F6	41.680	41.080	Type 3	Ø 460mm	B125	0.600
F7	41.680	40.545	Type 3	Ø 460mm	B125	1.135
EXISTING	41.240	41.240 min	Type 3	Brick	B125	0.815 min.

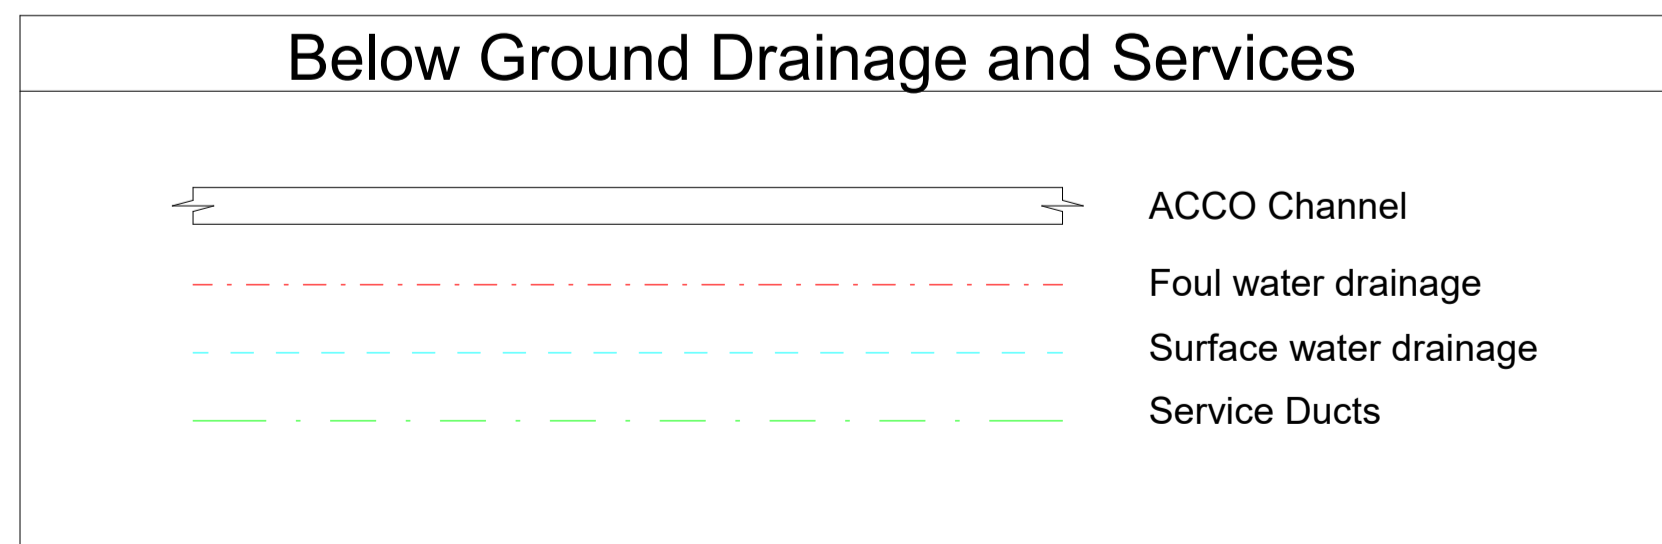

Rev	Description	Date	Dr. by	App. by
A	Various amendments	22.11.19	BOD	DW
B	Steelwork shown, blockwork setting out dimensions provided in RED	29.11.19	BOD	DW
C	Various amendments	10.12.19	BOD	DW

dewis
ARCHITECTURE

Menai House
Holyhead Road
Llanfairpwll
Anglesey
LL61 5UJ

01248 715006
info@dewis.uk.co
m
www.dewis.uk.co
m

Syrfewyr Siartredig Adeiladu
Rheolwyr Proiect
Ymgynghorwyr Pensaernïol
Ymgynghorwyr Adeiladau Hanesyddol

Chartered Building Surveyors
Project Managers
Architectural Consultants
Historic Building Consultants

Client
MacLennan Construction

Project
Bangor Cricket Club

Drawing
Foul Drainage Plan

Drwg. No. D714.12	Rev. C	Scale As Indicated	Drawn by BOD
Plot Date 10.03.2020	Size A1	Issue Status As Built	Approved by DW

This drawing must be read in conjunction with all related drawings. All dimensions must be checked and verified on site before commencing any work or producing shop drawings. The originator should be notified immediately of any discrepancies. Only figured dimensions are to be worked to. This drawing is copyright and remains the property of DEWIS architecture.